


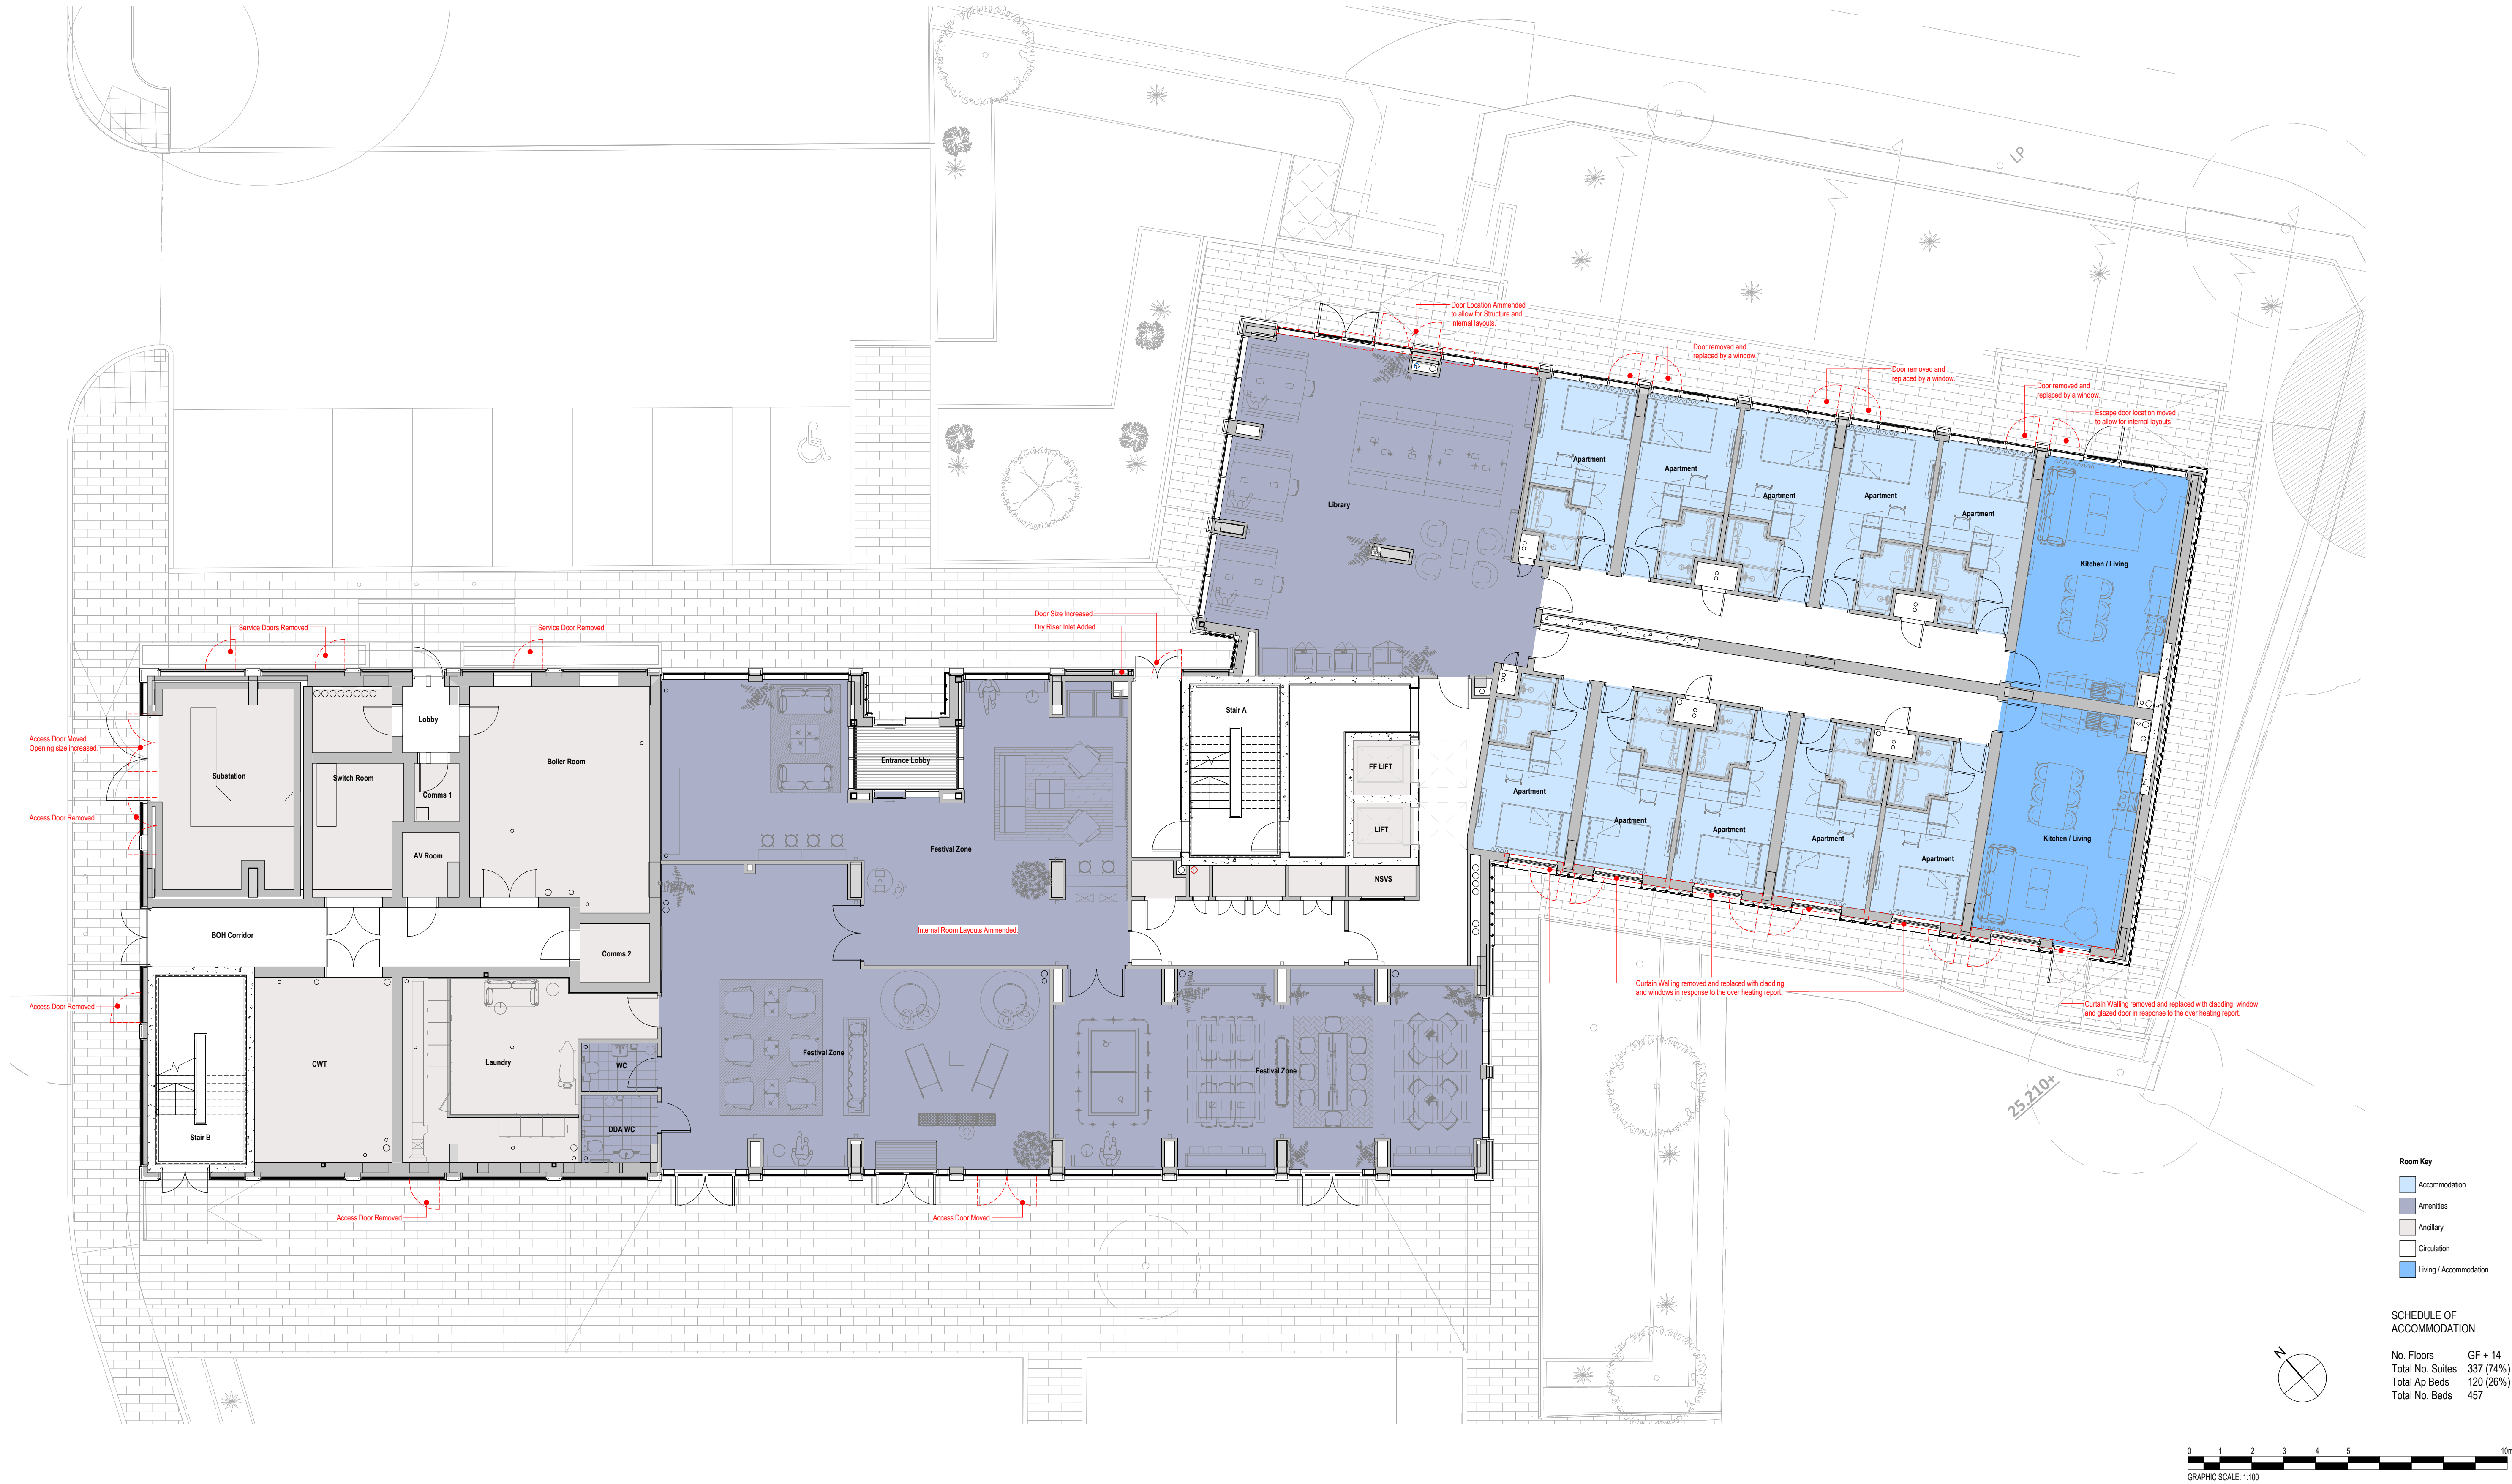

Room Key	
	Accommodation
	Amenities
	Ancillary
	Circulation
	Living / Accommodation

SCHEDULE OF ACCOMMODATION

No. Floors	GF + 14
Total No. Suites	337 (74%)
Total Ap Beds	120 (26%)
Total No. Beds	457

GENERAL NOTES:

- DAY Architectural Ltd accepts no responsibility for any costs, losses or claims whatsoever arising from these drawings, specifications and related documents unless there is full compliance with the Client or any unauthorised user of the following:
- 1 All boundaries, dimensions and levels are to be checked on site before construction and any discrepancies reported to the Architect / Designer.
 - 2 Partial Service: Any discrepancies with site or other information is to be advised to the Architect / Designer and direction and / or approval is to be sought before the implementation of the detail.
 - 3 Block and site plans are reproduced under license from the Ordnance Survey.
 - 4 Do not scale this drawing.
 - 5 For the purpose of coordination, all relevant parties must check this information prior to implementation and report any discrepancies to the Architect / Designer.

Note: Red notes and dashed red lines indicate changes from the original Planning Submission.

REV	DESCRIPTION	DATE	REV BY	CHKD BY
A	Issued for Planning.	01.06.22	RJ	RJH

CLIENT
Graham's Contractors Ltd

PROJECT
Discovery Quays 2

DRAWING STAGE
STAGE 3b

DRAWING
Level 0 GA Plan

SCALE
1 : 100 @ A1

FIRST ISSUED
30/05/22

PROJECT		DRAWN BY		CHECKED BY		
1074-20		RJ		RJH		
ORIGIN	VOLUME	LEVEL	TYPE	ROLE	NUMBER	REVISION
DAY	XX	00	DR	A	04-0100	A

DRAWING STATUS
PLANNING

Information contained on this drawing is the sole copyright of DAY Architectural Ltd. and is not to be reproduced without their permission

DAY

DAY Architectural Ltd.
Studio 1, Lancaster Buildings
77 Deansgate, Manchester, M3
2BW

T: 0161 834 9703
W: www.day-architectural.com