


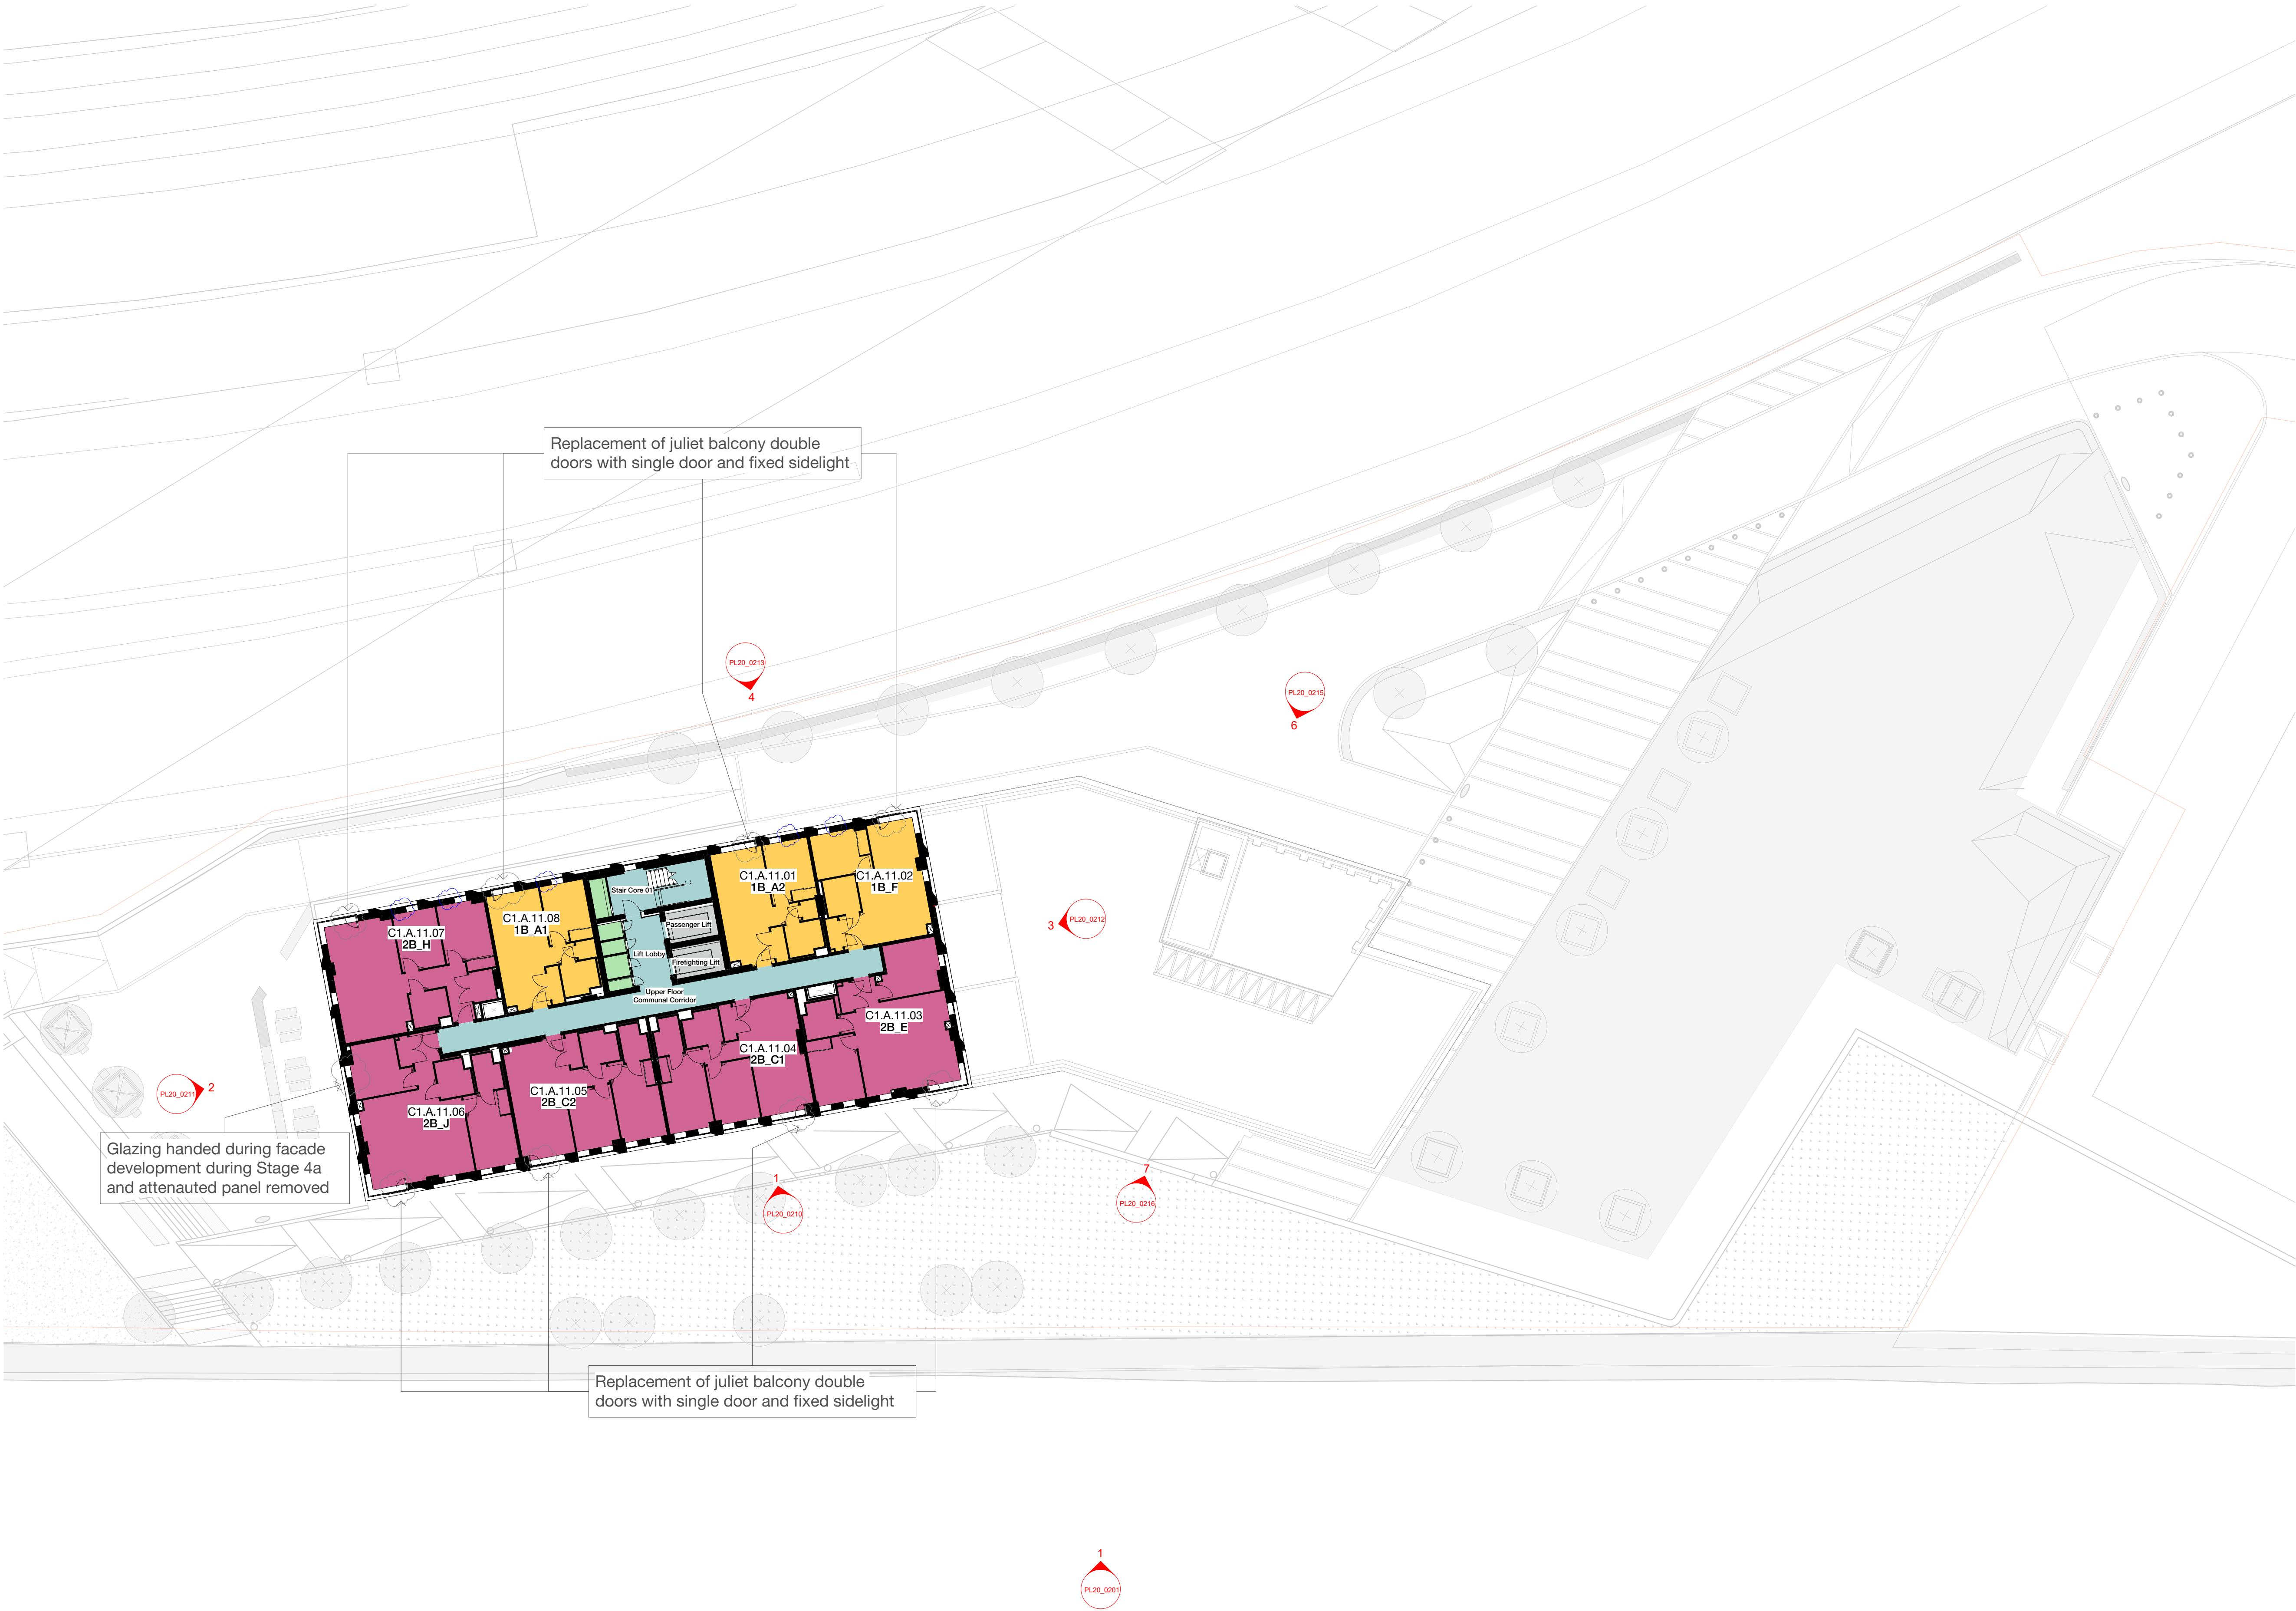

Copyright Hawkins\Brown Architects
No implied licence exists. This drawing should not be used to calculate areas for the purposes of valuation. Do not scale this drawing. All dimensions to be checked on the site by the contractor and such dimensions to be their responsibility. All work must comply with relevant British Standards and Building Regulations requirements. Drawing errors and omissions to be reported to the architect. To be read in conjunction with Architect's specification and other consultant information.

Rev	Description	Date
P1	Planning Issue	02.05.19
P2	Planning Landscape Revision	10.05.19
P3	Planning Sign-Off	17.05.19
P4	Planning Landscape Revision 2	31.05.19
P5	Planning Drawing Updates Following Design Development	06.09.19
P6	Planning Non-Material Amendments	05.02.20

GA Plan Key

- 1 Bedroom Unit
- 2 Bedroom Unit
- 3 Bedroom Unit
- Plant Room
- Circulation
- Core Risers
- Red Line Boundary

PLEASE NOTE:


Update to facade chamfers - rationalisation and reduction in types

Update to projecting and corner balcony balustrades - replacement of laminated glass balustrades with PPC aluminium balustrades with perforated design.

Update to juliet and recessed balcony balustrades - replacement of laminated glass balustrades with flat rail steel design.

Update to ventilation strategy to north and west facades - removal of attenuated panels.

Refer to elevation and bay study drawings.

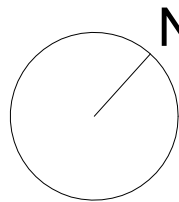

3C Tariff Street
Manchester M1 2FF

mail@hawkinsbrown.com
hawkinsbrown.com

Hawkins\Brown

Project
Salford Central
Trinity Way, Salford

Drawing
Proposed Level 11 GA Plan

Scale @ A1
1 : 200

Date
May 2019

Drawn By
HECW

Checked By
RM

Job Number
17048

Status
S2

Purpose of Issue
Planning

Drawing No.
SALC-HBA-C1-11-DR-A-PL20_0111

Rev
P6